




FLOOR PLAN  
SCALE: 3/16" = 1'-0"

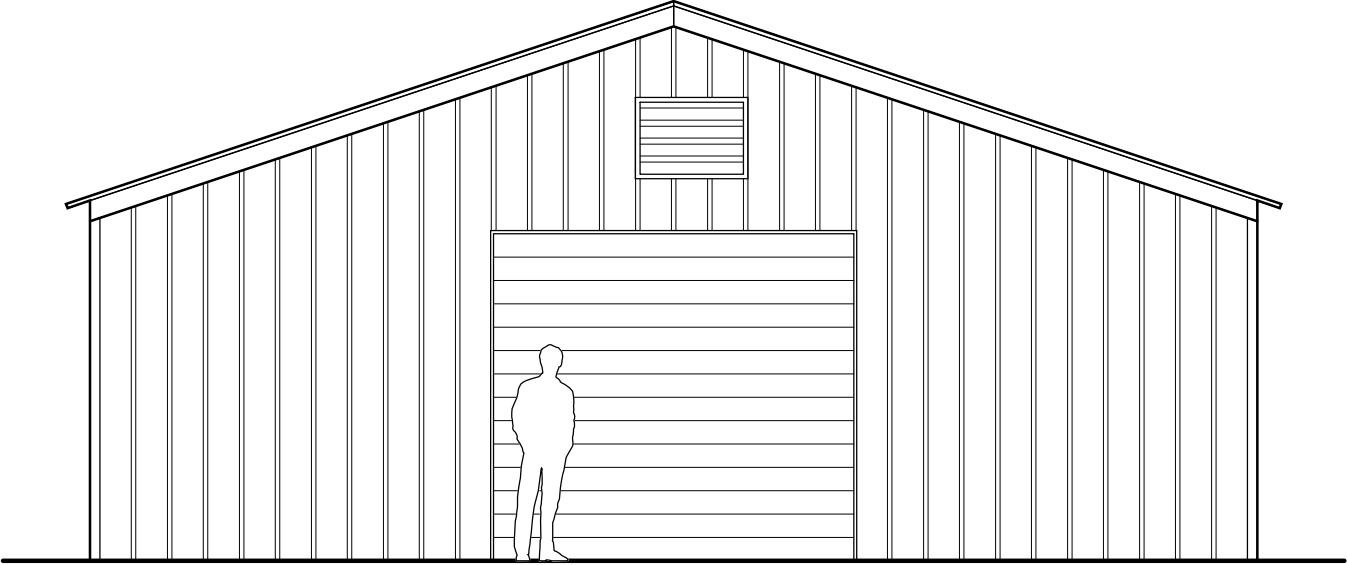


FRONT (NORTH) ELEVATION - CARTON STREET

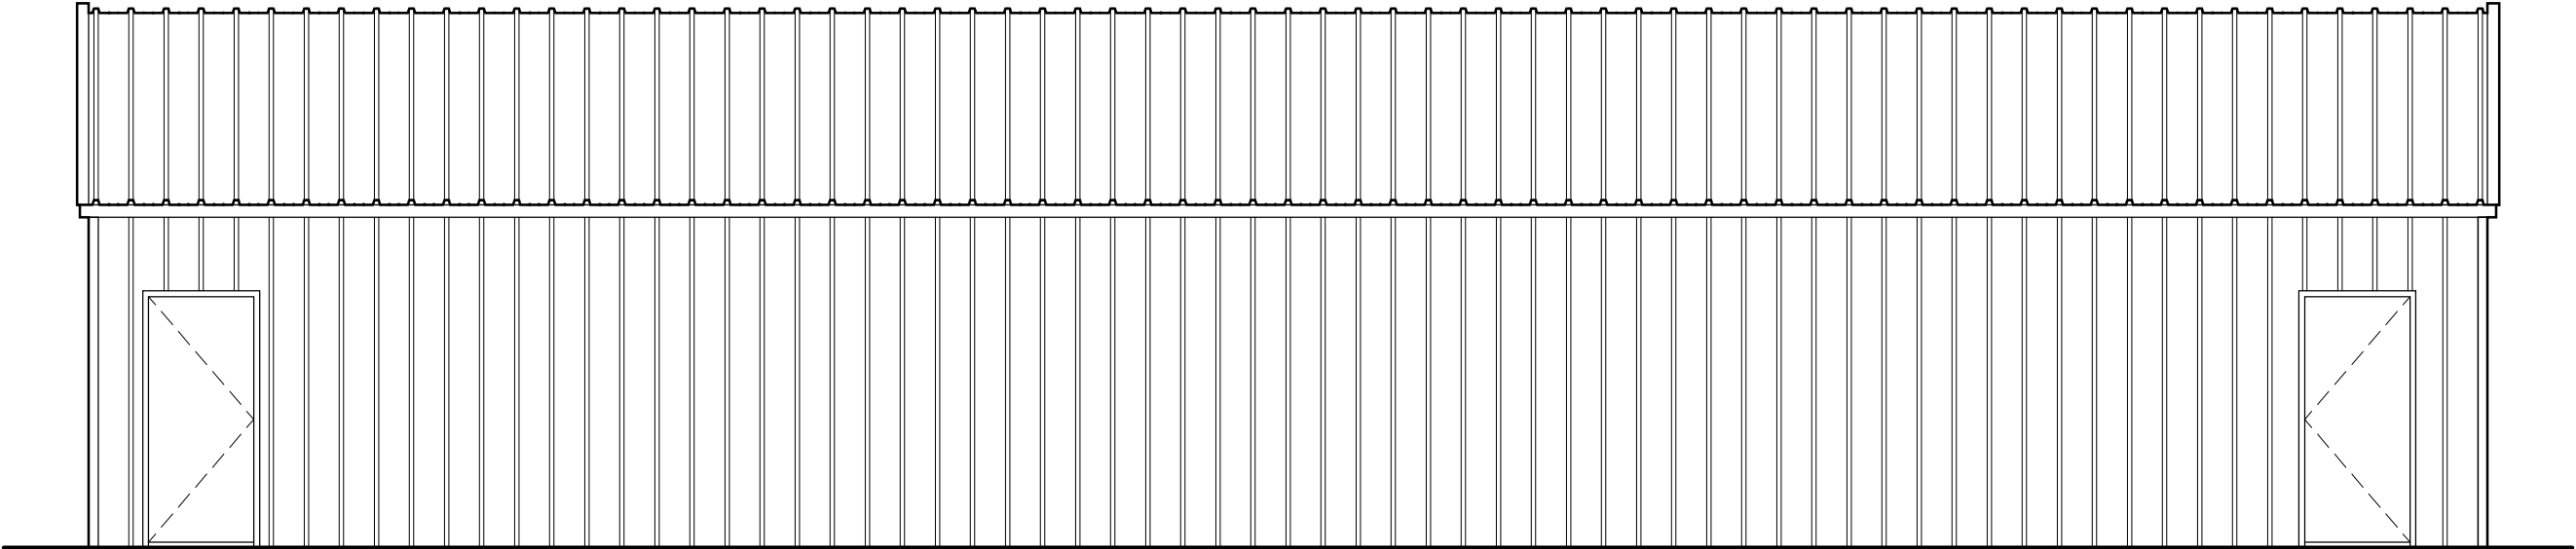


SIDE (WEST) ELEVATION

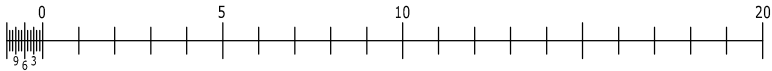


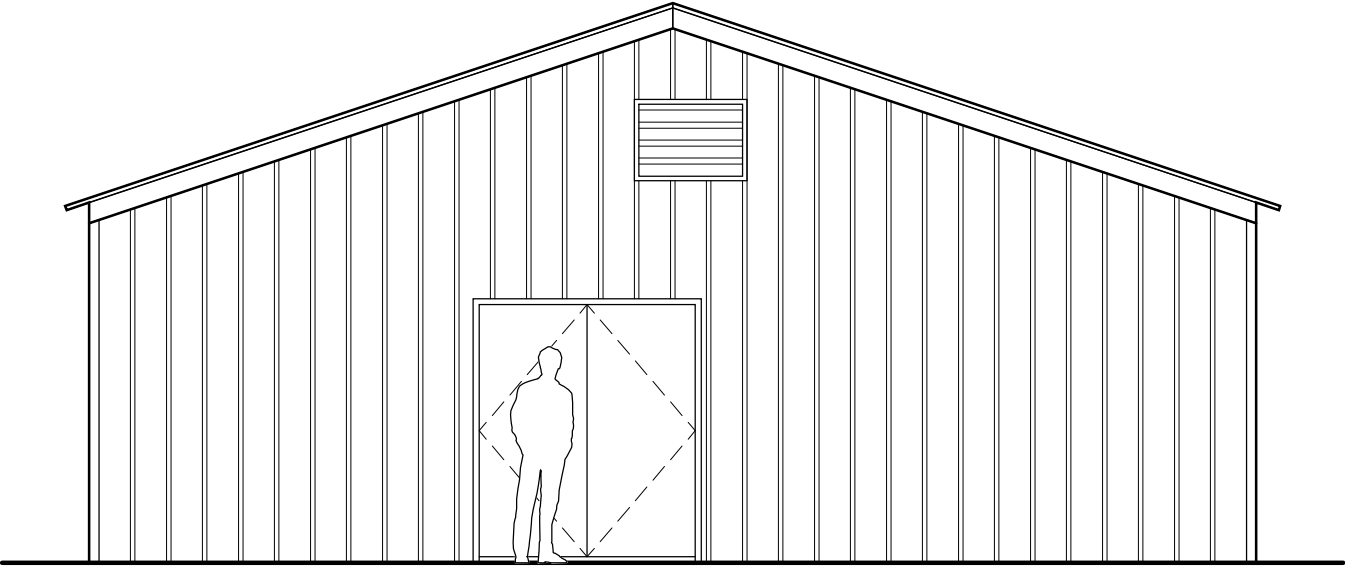

REAR (SOUTH) ELEVATION


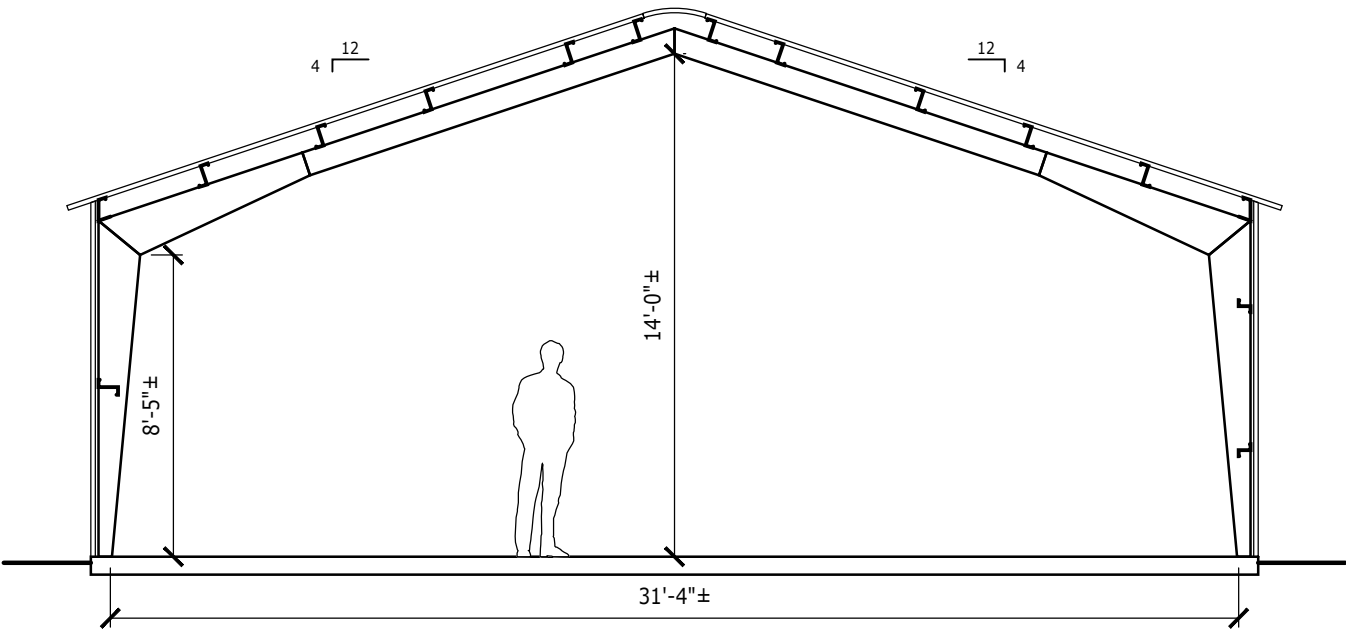


BUILDING SECTION

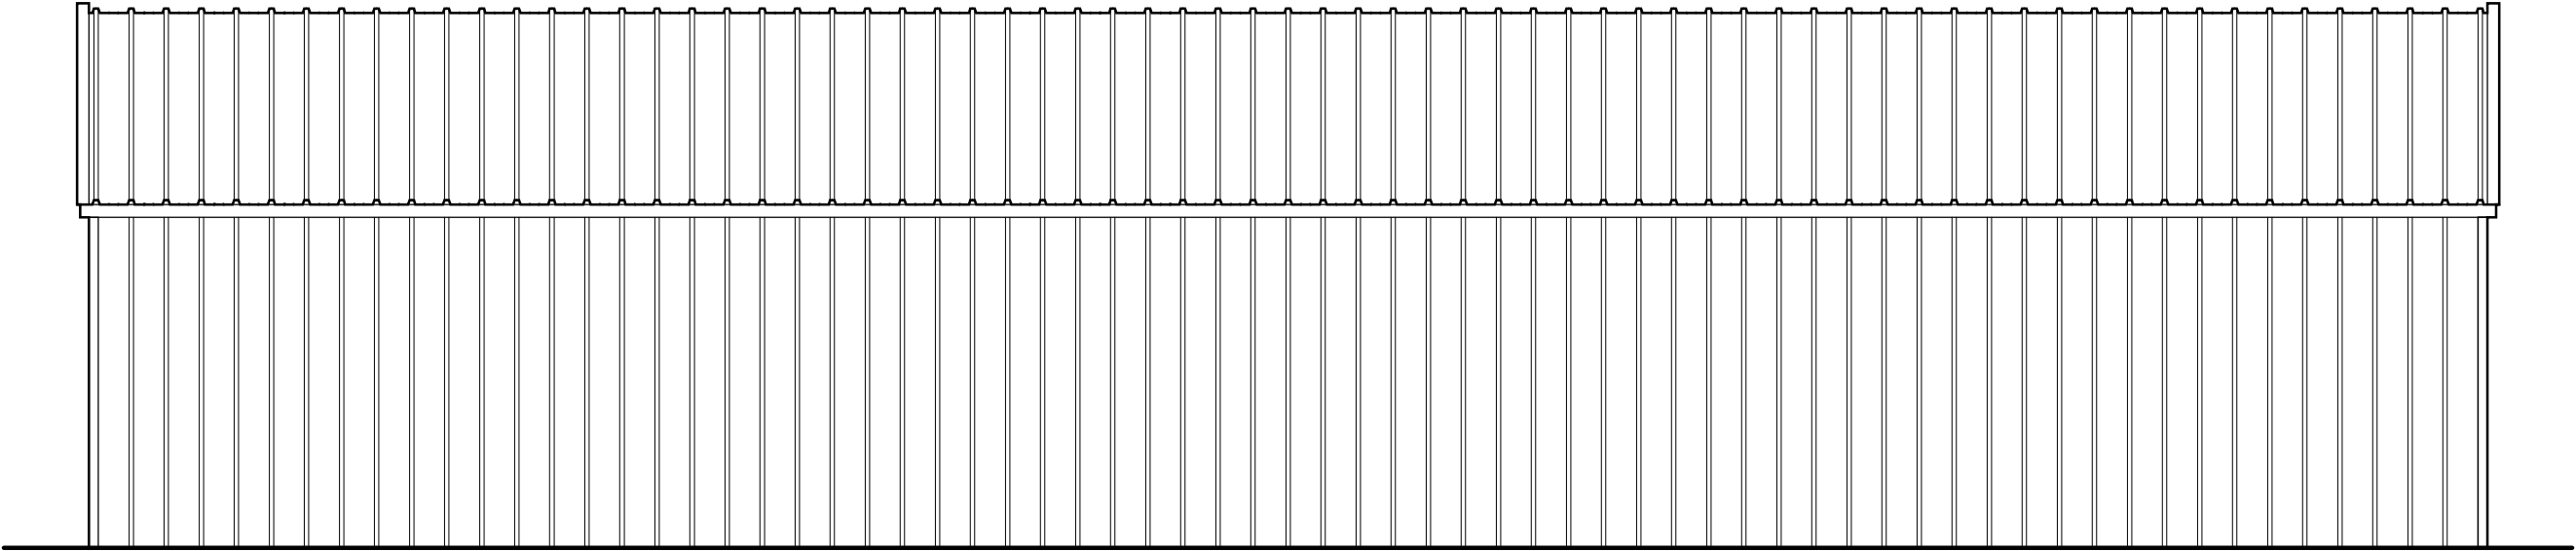

SIDE (EAST) ELEVATION



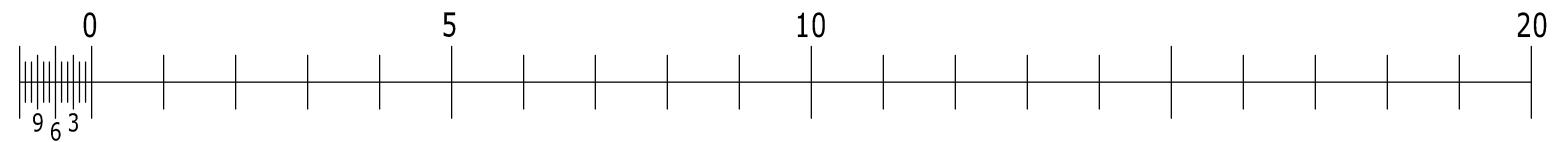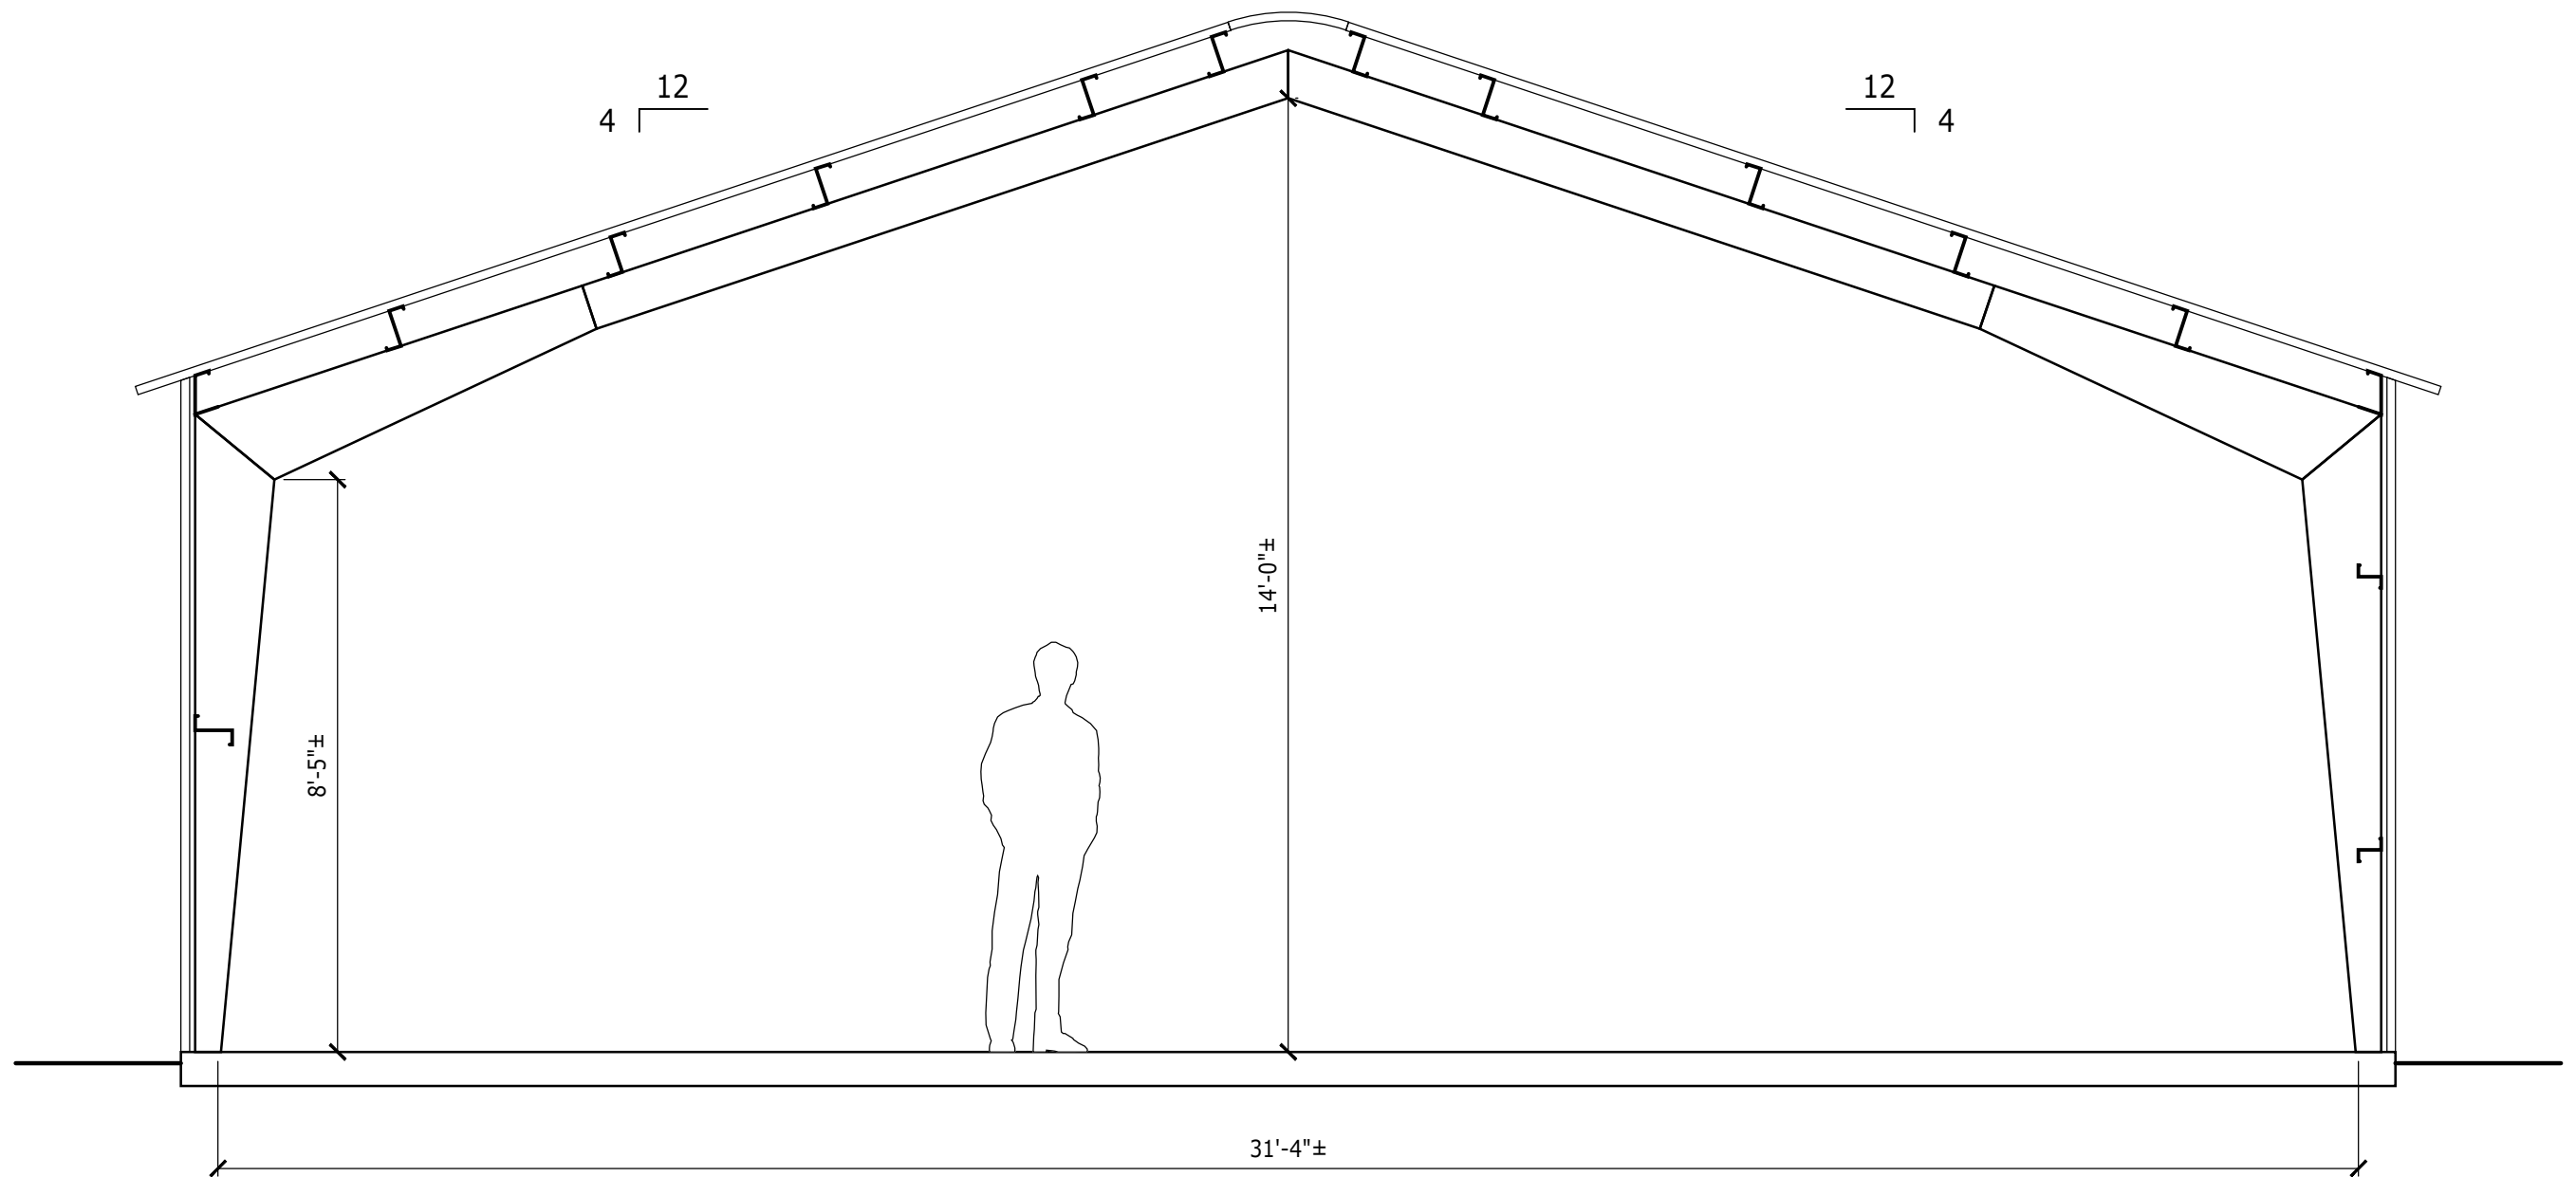

**BUILDING SECTION**  
SCALE: 3/8" = 1'-0"

**RUMSON REC. EQUIPMENT SHED**  
3/8/24 RUMSON, NJ





VIEW FACING NORTH



VIEW FACING SOUTH